



T10N-R01E-32_0000_MCS

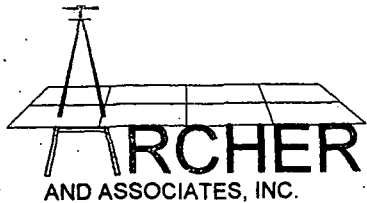

Steve Archer
P.O. Box 1296
Bloomington, IN 47402
(812) 334-8941
Fax (812) 323-7699

Owner of Record
Flowers/Grundhoefer
inst # 2002031213

Basis of Bearings
south line of the SE 1/4
of section 32-10N-1E
rotated to N 89°32'51"W
as per previous survey
by Archer on 3-30-01

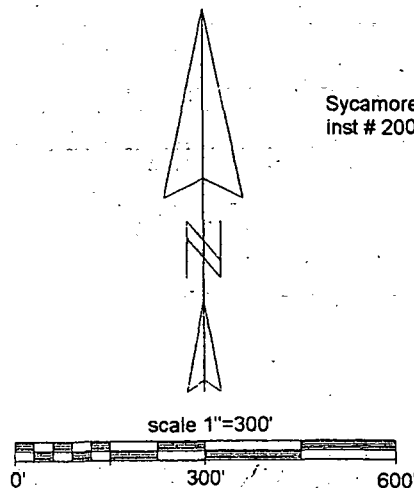

Sycamore Land Trust
inst # 2002017072

5/8" rebar
w/cap set

S 89°40'28"E
1984.49'

5/8" rebar
w/cap set

NW corner SW 1/4
SE 1/4 Sec. 32-10N-1E
Monroe County, IN

59.39 acres

N 0°37'41"E
1320.29'

N 0°32'34"E
1323.14'

S 87°14'28"W
82.64'

5/8" rebar
w/cap set

S 0°32'03"W
528.00'

Brosman/Palmer
dr 440 pg 219

Brosman/Palmer
dr 440 pg 219

Brosman/Palmer
dr 440 pg 235

Brosman/Palmer
dr 440 pg 236

Brosman, dr 227 pg 419

unrecorded deed

Shilo Road

5/8" rebar
w/cap set

SW corner SW 1/4
SE 1/4 Sec. 32-10N-1E
Monroe County, IN

N 89°32'51"W
1911.82'

5/8" rebar
w/cap set

Hutchins Trust
inst # 2003001980

Sec. 5-9N-1E

Hillsamer/Hutchins
inst # 1999020410


I, Steven W. Archer, hereby certify that I am a Registered Land Surveyor, licensed with the Laws of the State of Indiana, and that the above plat and descriptions correctly represent a land survey performed by me or under my direct supervision and that the monuments shown thereon actually exist and are to the best of my knowledge and belief accurately shown March 14th, 2003

Steven W. Archer
RLS 8700094



JANETT

849.96' SOUTH &
138.94' WEST OF NW CORNER OF SW 1/4 OF NW 1/4 OF SEC. 33-10N-1E

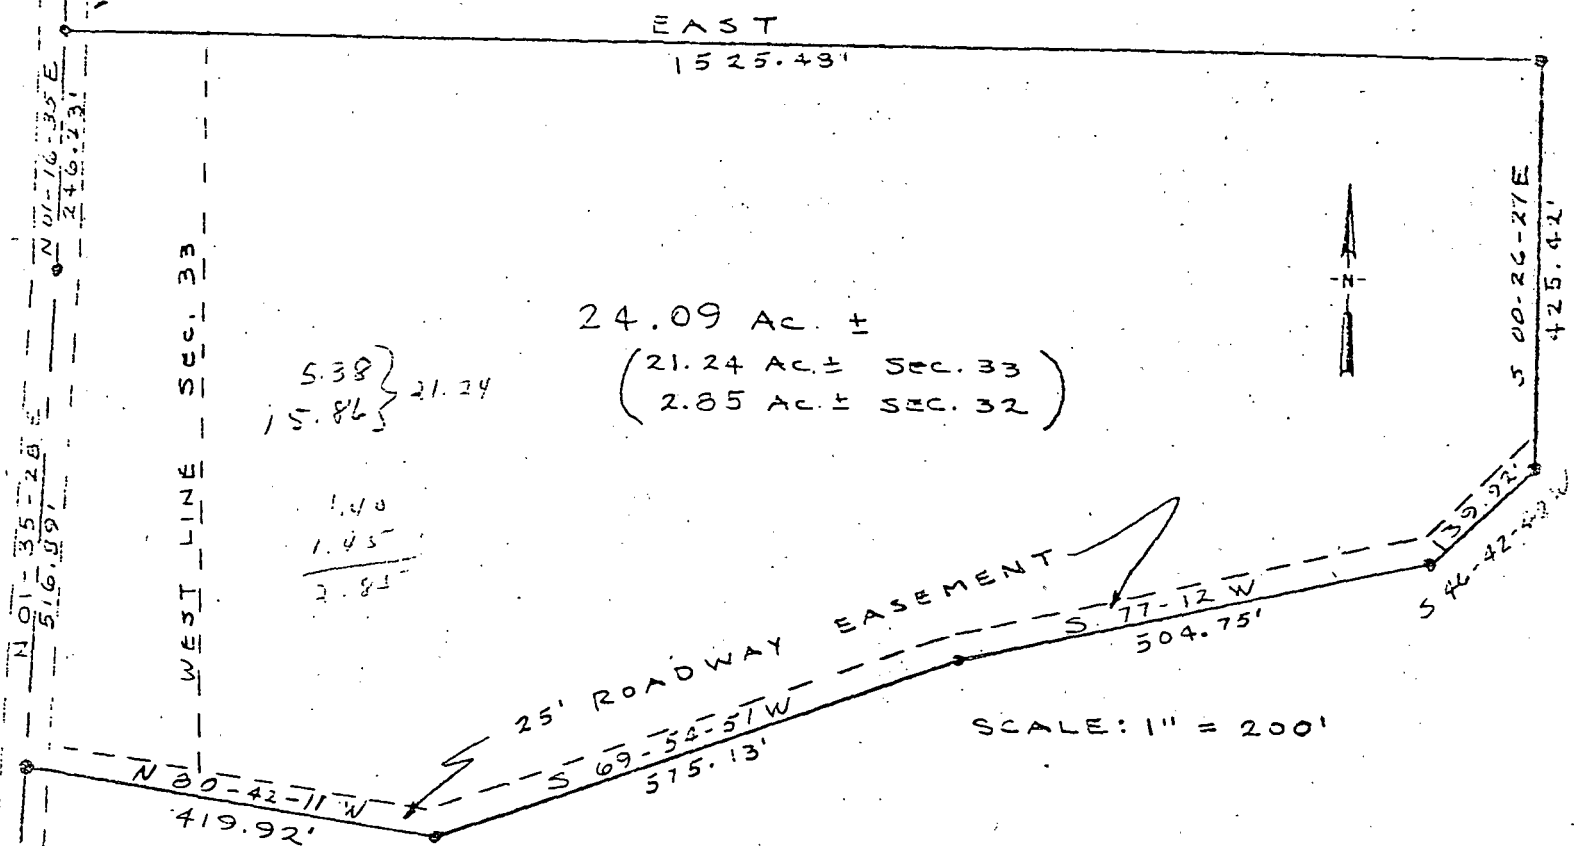

Legal Description:

A part of the West one half of Section Thirty-three (33), Township Ten (10) North, Range One (1) East, and a part of the East one half of Section Thirty-two (32), Township Ten (10) North, Range One (1) East, all being in Monroe County, Indiana, described as follows:

Beginning at a point on the centerline of Shiloh Road, said point being 849.96 feet South and 138.94 feet West of the Northwest corner of the Southwest quarter of the Northwest quarter of said Section 33, thence East 1525.48 feet; thence South 26 minutes 27 seconds East 425.42 feet; thence South 46 degrees 42 minutes 40 seconds West 139.92 feet; thence South 77 degrees 12 minutes West 504.75 feet; thence South 69 degrees 54 minutes 51 seconds West 575.13 feet; thence North 80 degrees 42 minutes 11 seconds West 419.92 feet to a point on the centerline of Shiloh Road; thence on said centerline North 01 degrees 35 minutes 28 seconds East 516.39 feet; thence continuing on said centerline North 01 degrees 16 minutes 35 seconds East 246.23 feet to the point of beginning, containing 21.24 acres, more or less, in Section 33 and 2.85 acres, more or less, in Section 32, containing in all 24.09 acres, more or less.


Subject to an easement for a roadway, said easement being 25 foot of even width off the Southerly side of above described tract.

Survey and Description by: Robert C. Sipes, IND LS No. 9016

Robert C. Sipes

TRACT Four --- John S. Burns and June E. Burns

JANE ELLER

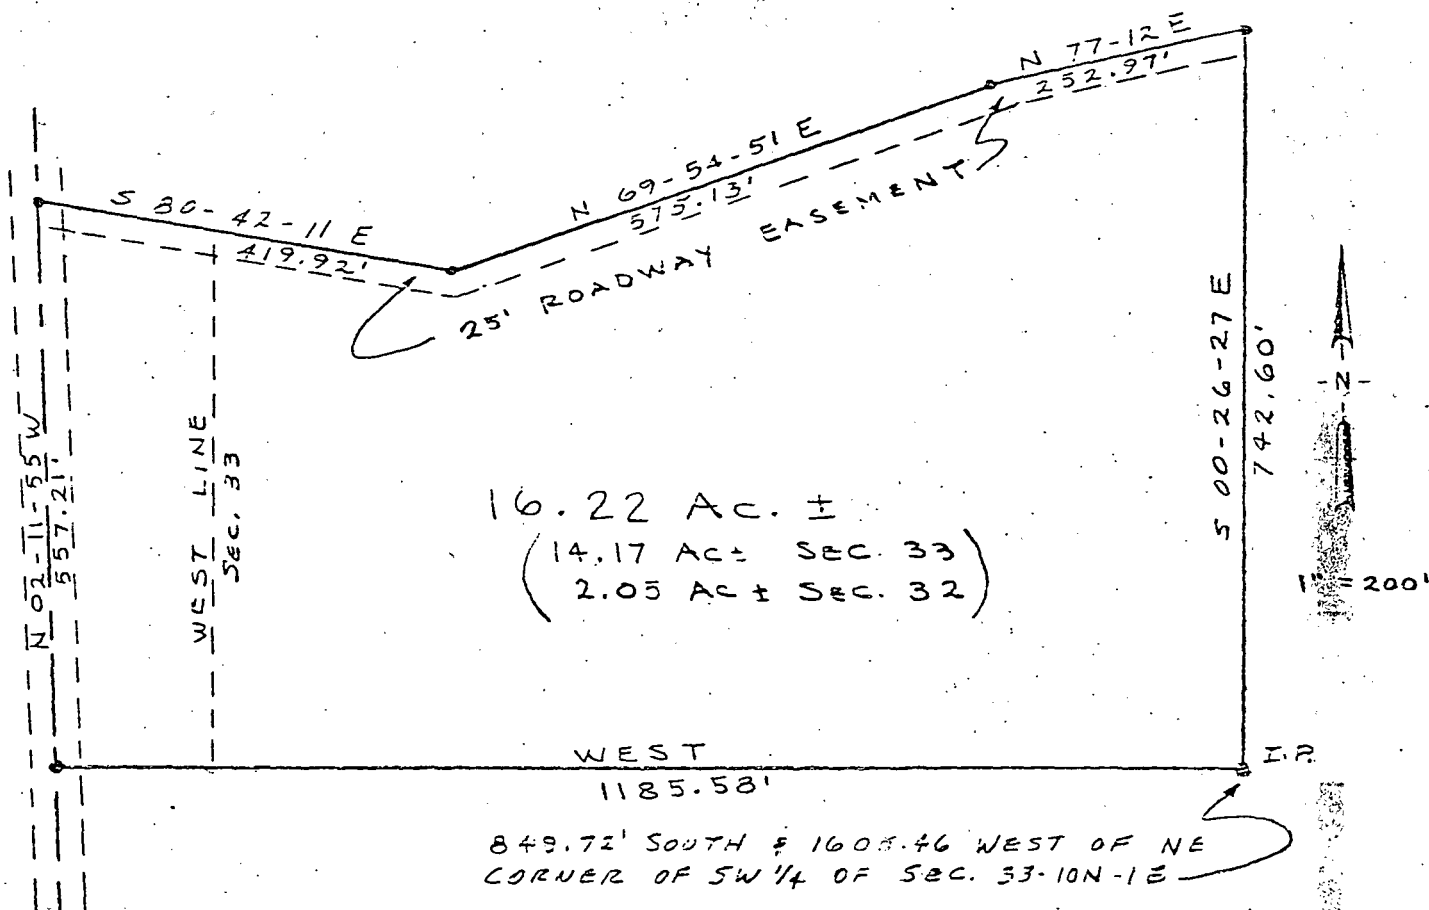

PLAT OF SURVEY

Date: Feb. 5, 1980

LEGAL DESCRIPTION:

A part of the Southwest quarter of Section Thrity-three (33), Township Ten (10) North, Range One (1) East and a part of the Southeast quarter of Section Thrity-two (32), Township Ten (10) North, Range One (1) East, all being in Monroe County, Indiana, described as follows:

Beginning at a point that is 849.72 feet South and 1605.46 feet West of the Northeast corner of said Southwest quarter of Section 33, thence West 1185.58 feet to a point on the centerline of Shiloh Road; thence on said centerline North 02 degrees 11 minutes 55 seconds West 557.21 feet; thence leaving said centerline South 80 degrees 42 minutes 11 seconds East 419.92 feet; thence North 69 degrees 54 minutes 51 seconds East 575.13 feet; thence North 77 degrees 12 minutes East 252.97 feet; thence South 26 minutes 27 seconds East 742.60 feet to the point of beginning, containing 14.17 acres, more or less, in Section 33 and 2.05 acres, more or less, in Section 32, containing in all 16.22 acres, more or less.

Subject to an easement for a roadway, said easement being 25 feet of even width off the Northerly side of the above described tract.

Survey and Description by:

Robert C. Sipes
Robert C. Sipes, IND LS NO. 9016

Sec 33-10N-1E


Burns

2-6-80

(1)

J. H.

TRACT One --- John S. Burns and June E. Burns

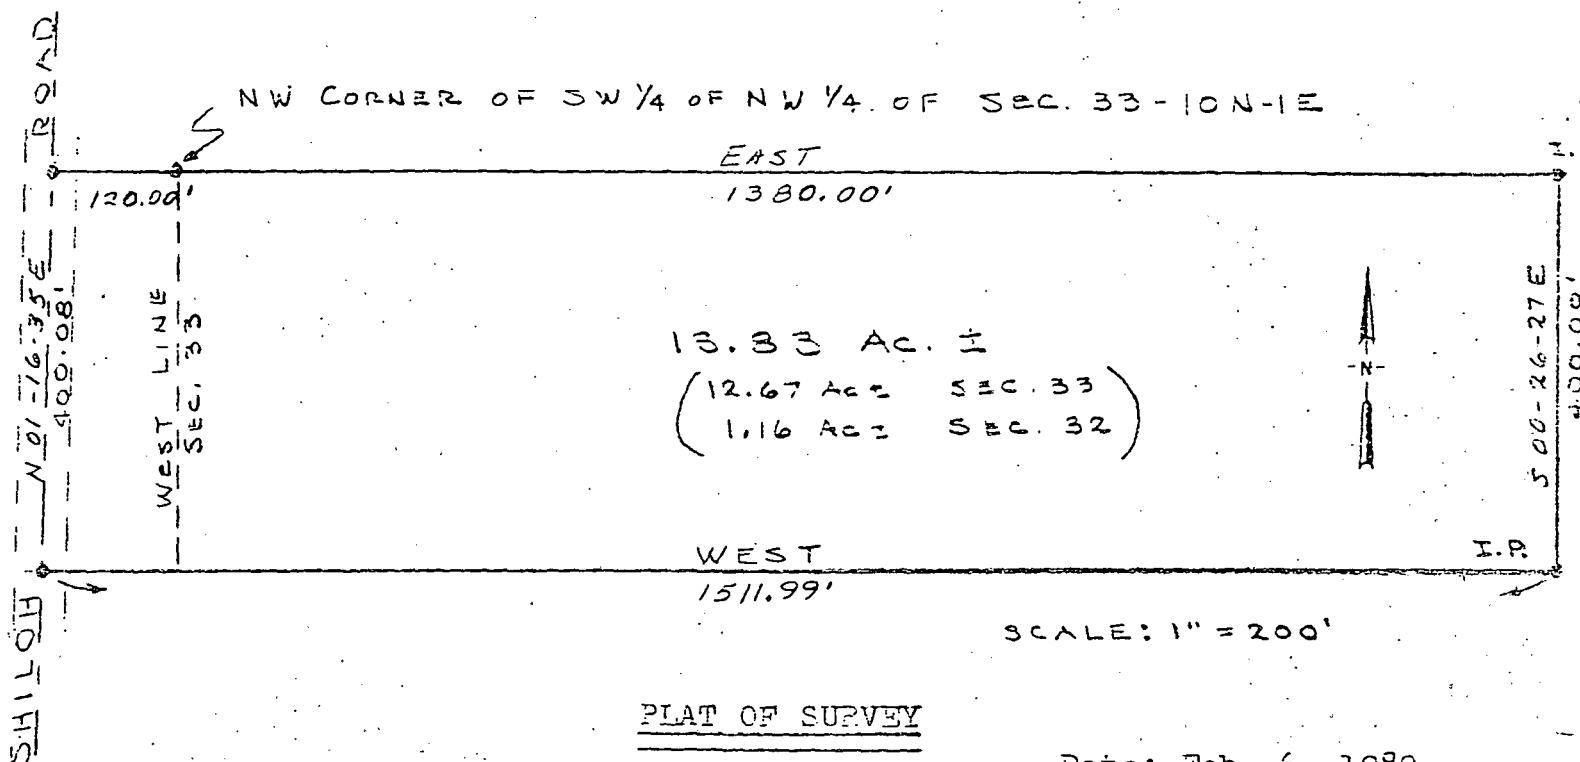

Legal Description:

A part of the South one half of the Northwest quarter of Section Thirty-three (33), Township Ten (10) North, Range One (1) East, and a part of the Southeast quarter of the Northeast quarter of Section Thirty-two (32), Township Ten (10) North, Range One (1) East, all being in Monroe County, Indiana, described as follows:

Beginning at the Northwest corner of the Southwest quarter of the Northwest quarter of said Section 33, Thence East 1380.00 feet; thence South 26 minutes 27 seconds East 400.00 feet; thence West 1511.99 feet to a point on the centerline of Shiloh Road; Thence on said centerline North 01 degrees 16 minutes 35 seconds East 400.08 feet; thence leaving said centerline East 120.00 feet to the point of beginning, containing 12.67 acres, more or less, in Section 33 and 1.16 acres, more or less, in Section 32, containing in all 13.83 acres, more or less.


Survey and Description by:

Robert C. Sipes

Robert C. Sipes, IND LS No. 9016

TRACT Two --- John S. Burns and June E. Burns

John Jay

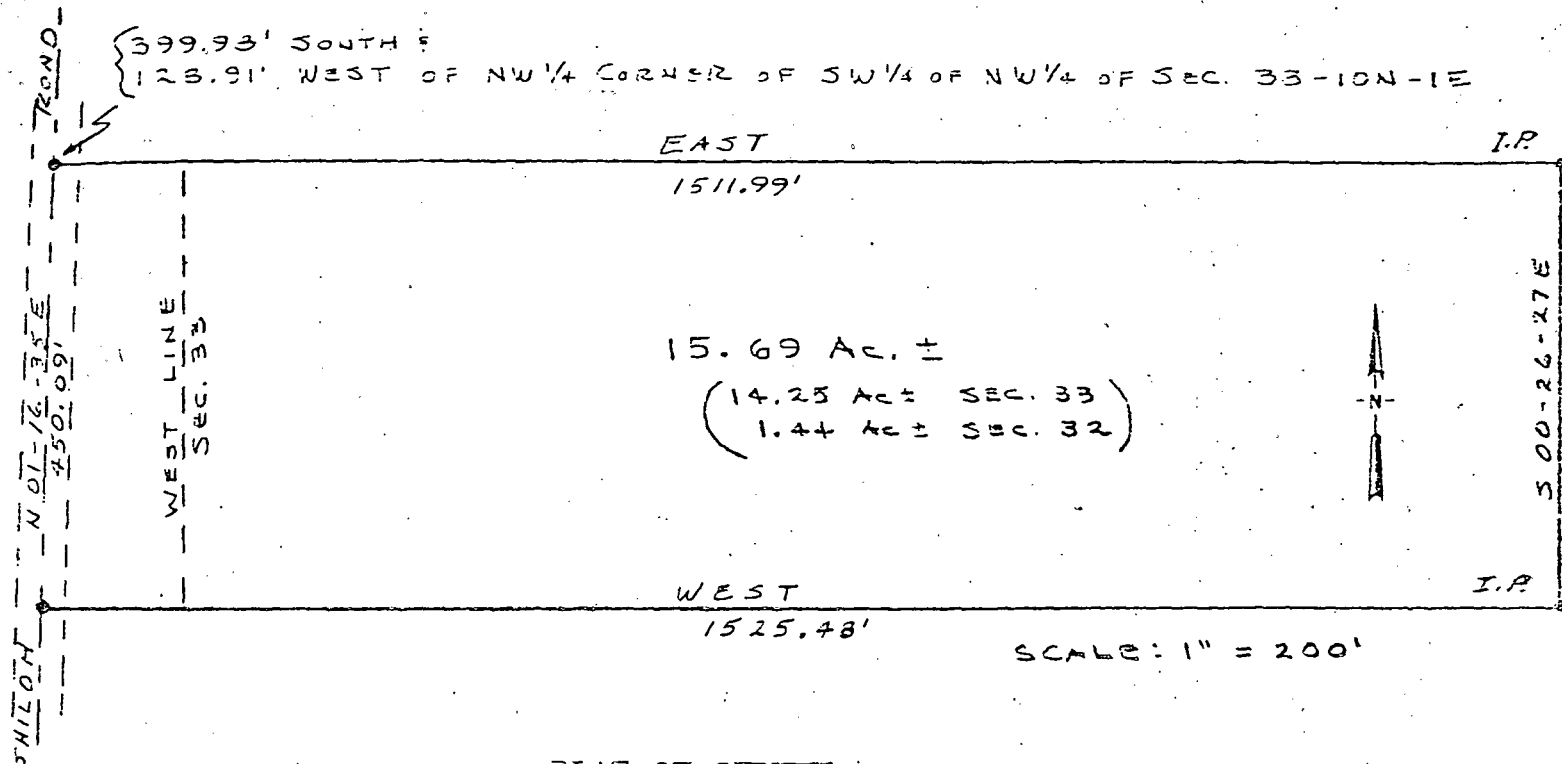

PLAT OF SURVEY

Date: Feb. 6, 1980


Legal Description:

A part of the South one half of the Northwest quarter of Section Thirty-three (33), Township Ten (10) North, Range One (1) East, and a part of the Southeast quarter of the Northeast quarter of Section Thirty-three (33), Township Ten (10) North, Range One (1) East, all being in Monroe County, Indiana, described as follows:

Beginning at a point on the centerline of Shiloh Road, said point being 399.98 feet South and 128.91 feet West of the Northwest corner of the Southwest quarter of the Northwest quarter of said Section 33, thence East 1511.99 feet; thence South 26 minutes 27 seconds East 450.00 feet; thence West 1525.48 feet to the centerline of Shiloh Road; thence on said centerline North 01 degrees 16 minutes 35 seconds East 450.09 feet to the point of beginning, containing 14.25 acres, more or less, in Section 33 and 1.44 acres, more or less, in Section 32, containing in all 15.69 acres, more or less.

Survey and Description by:

Robert C. Sipes
Robert C. Sipes, IND LS No. 9016

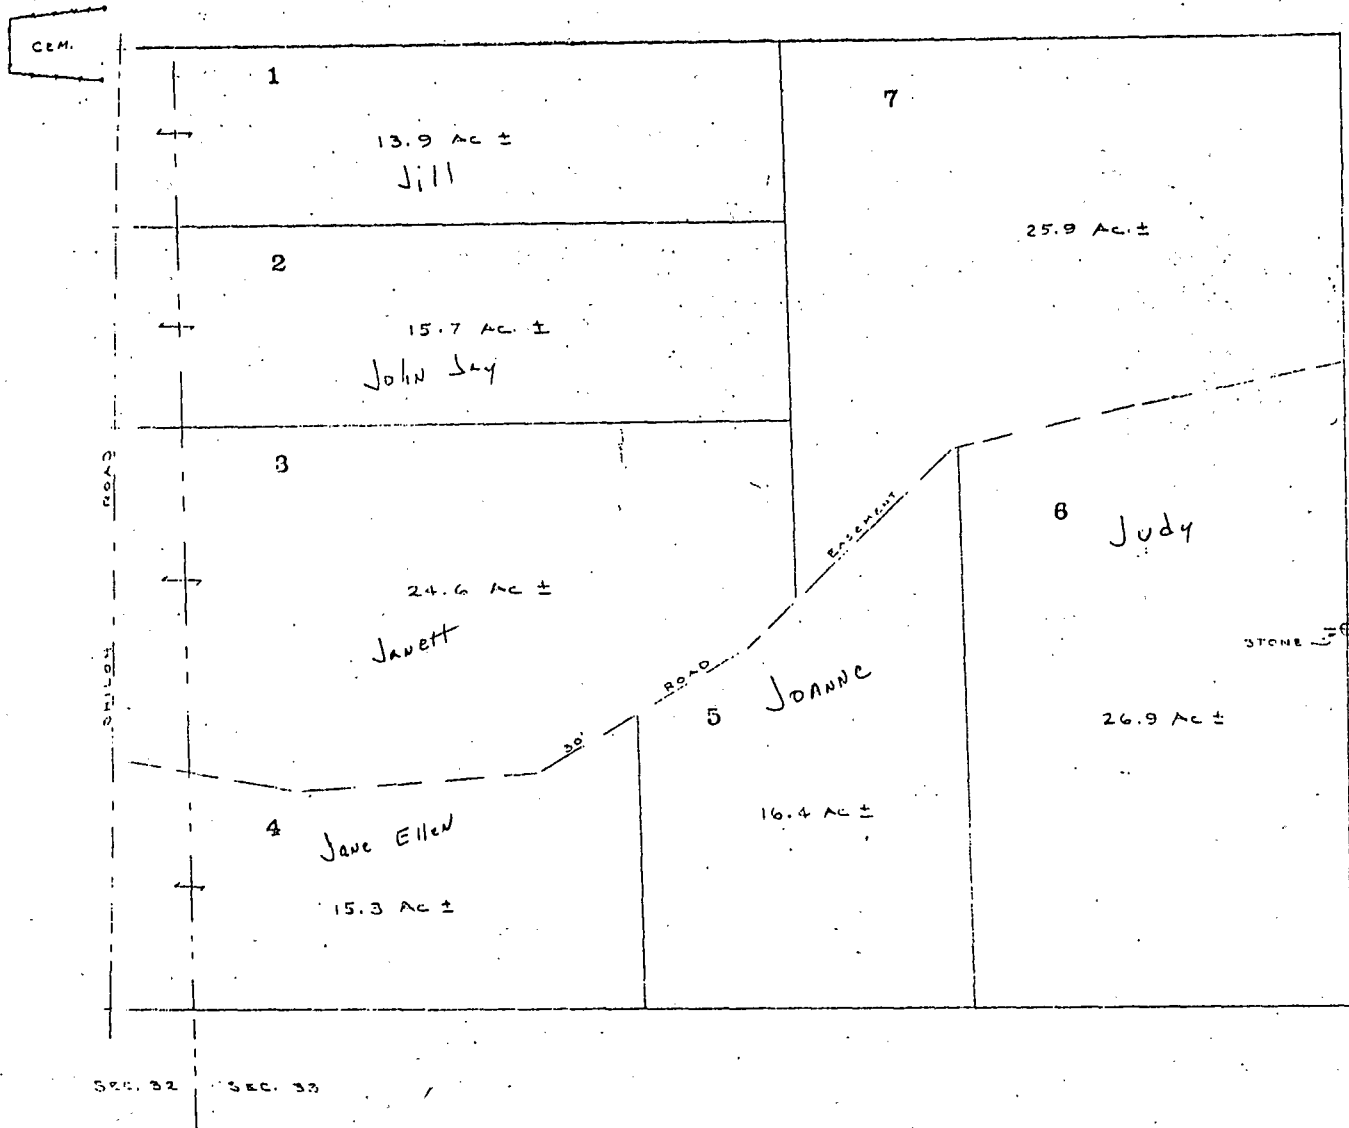


JOHN S. & JUNE BURNS			
PT of SEC'S. 32 & 33 - TION-AIR			
SCALE 1" = 200'	ATTACHED BY	PREP BY	
10/12/1972	ROBERT C. Sipes	JCB	
		DATE	

Owner of Record
Roxanne Flowers
Inst# 2001008448


Basis of Bearings

Stones found on the East line
of the SW 1/4, NW 1/4, Section
32-10N-1E rotated to N 00°07'E
as per previous survey by Doug
Curry on 2-11-99 and recorded
cabinete B envelope 151

- Ben No G-23
bk 36 p 55
Sec 32 E 1/4
- Iron pin/pipe found
 - ▲ R.R. Spike set
 - Stone Found
 - ⊗ 5/8" rebar w/cap found
 - 5/8" rebar w/cap set


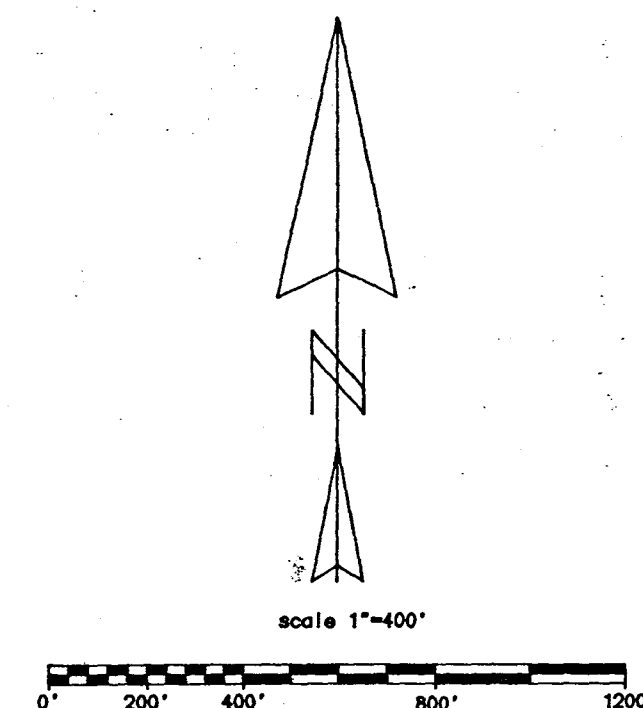


Ben No C-23
Sec 32 W 1/4
Pb 36 p 57

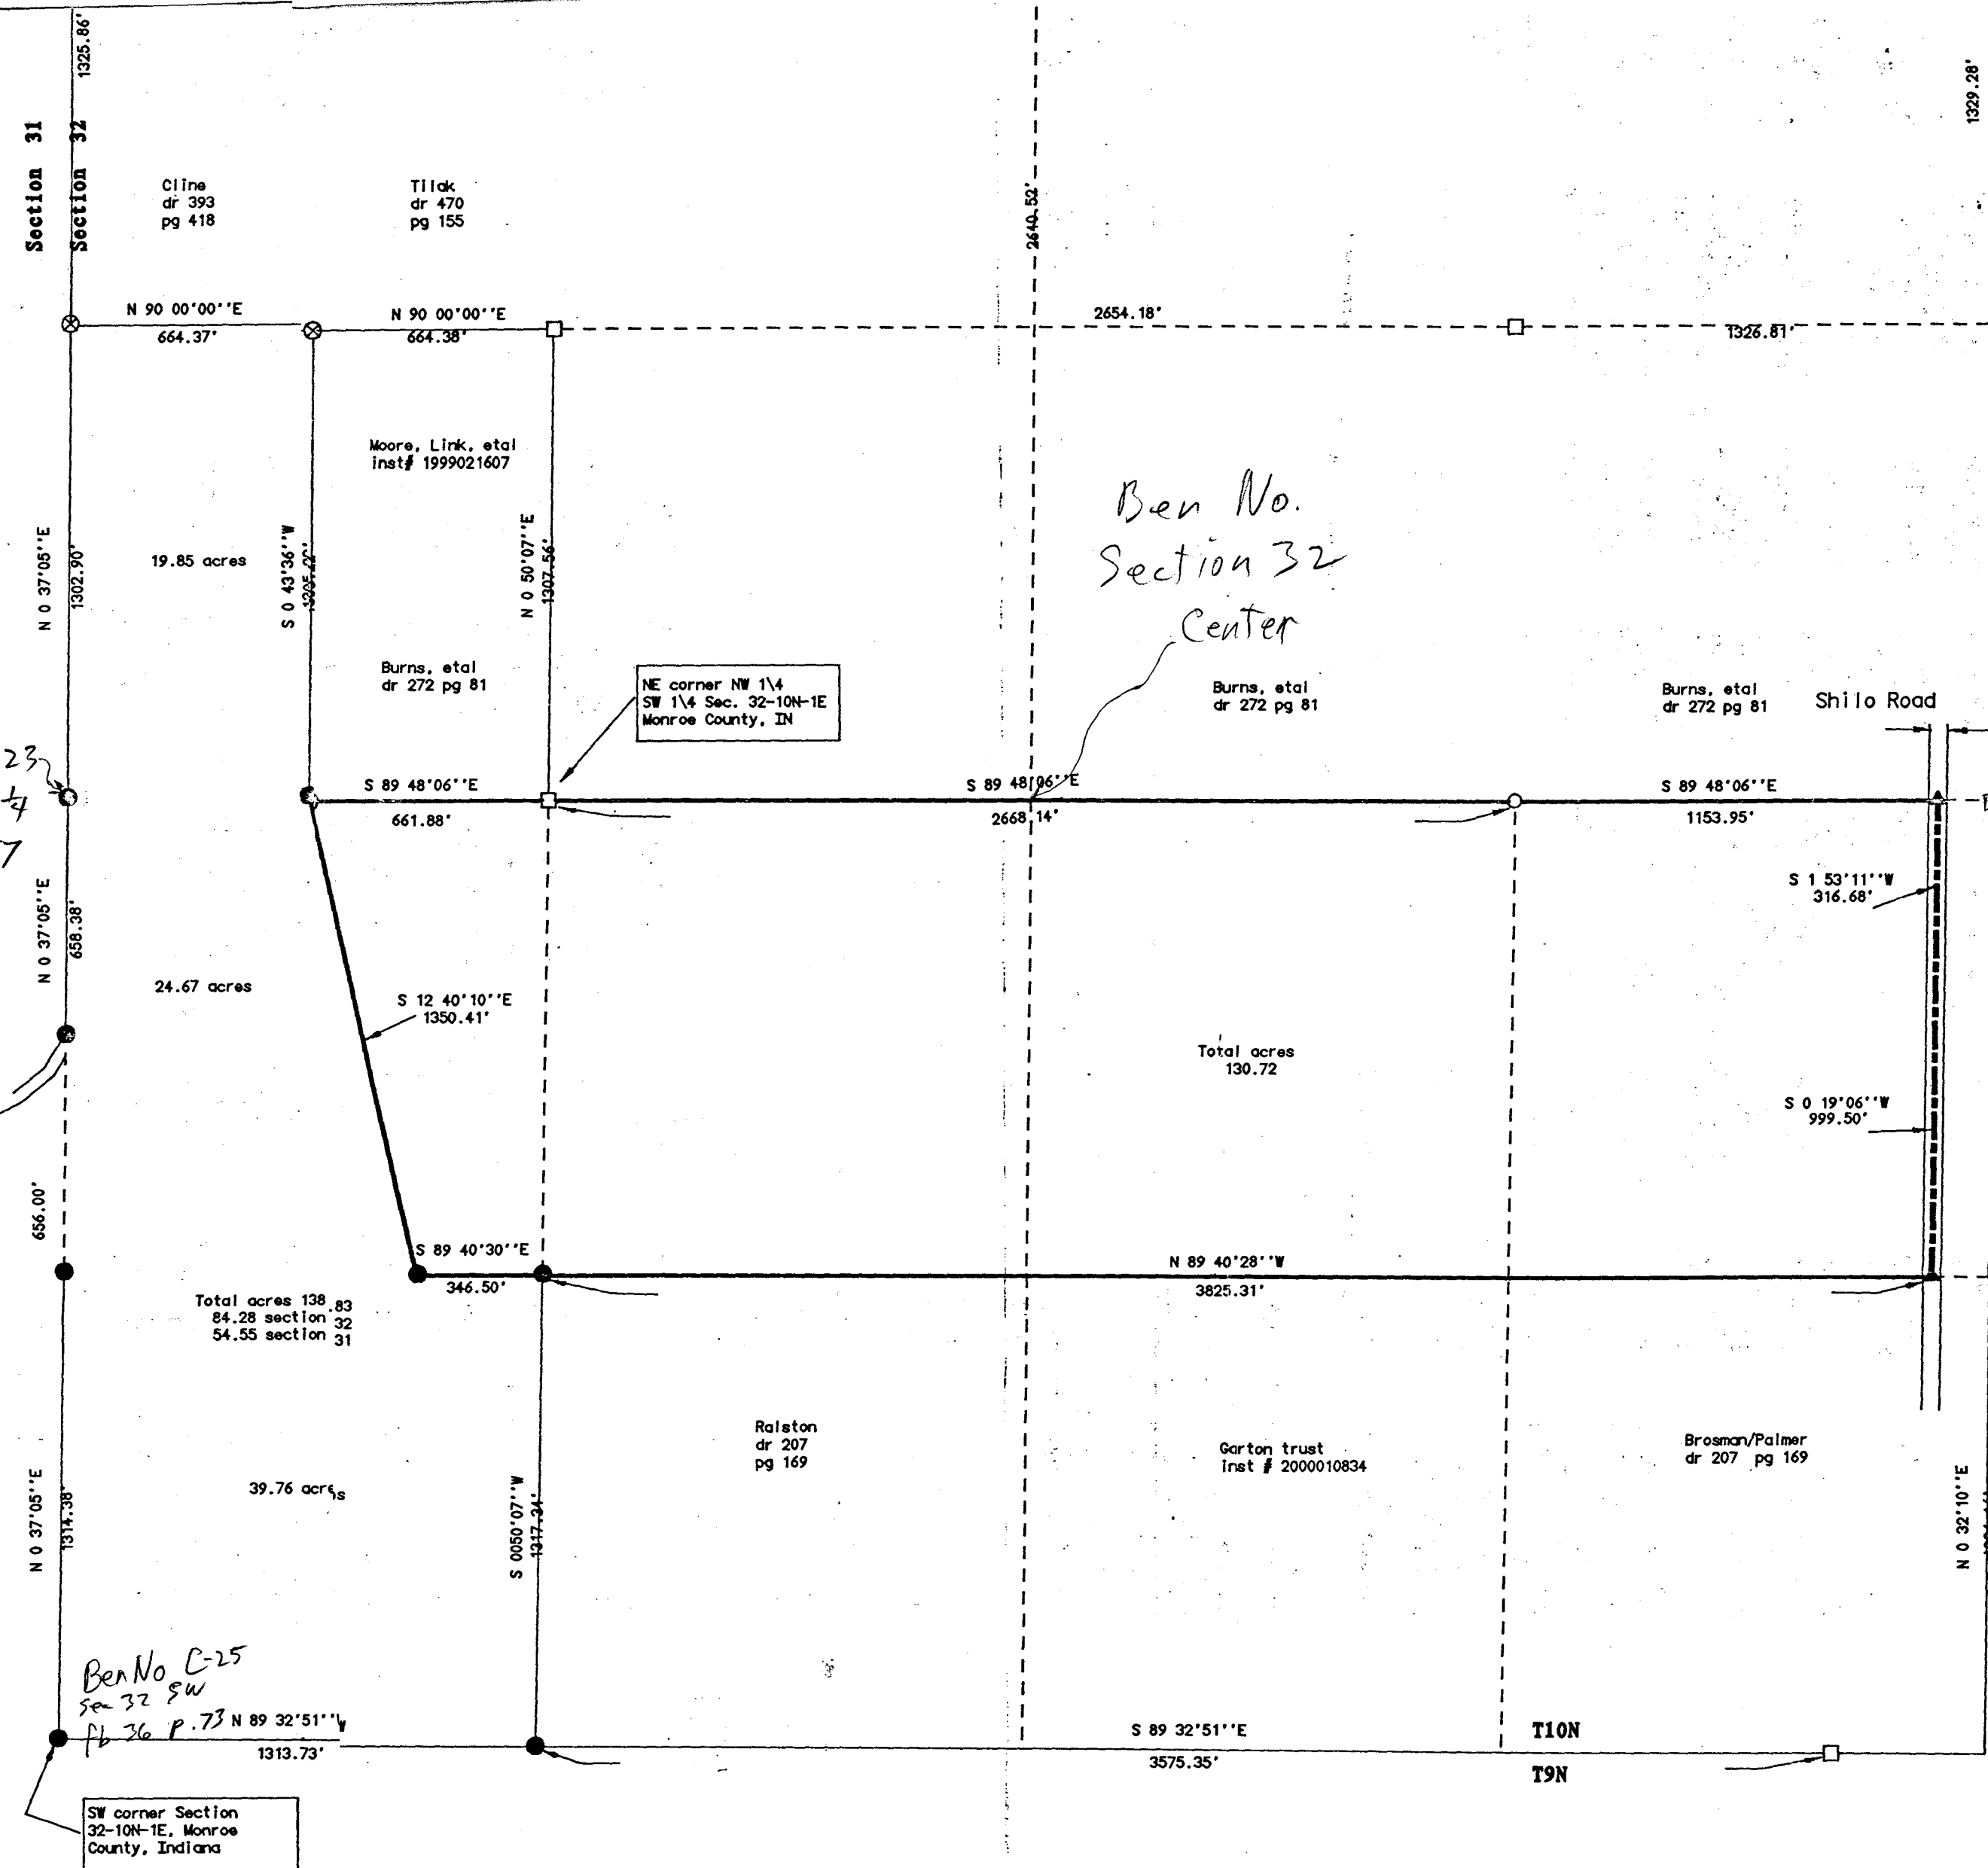

I, Steven W. Archer, hereby certify that I am a Registered Land Surveyor,
licensed with the Laws of the State of Indiana, and that the above plat and
descriptions correctly represent a land survey performed by me or under
my direct supervision and that the monuments shown thereon actually exist
and are to the best of my knowledge and belief accurately shown.
April 5th, 2001


Steven W. Archer
RLS 8700094

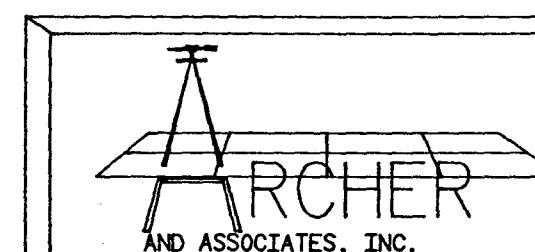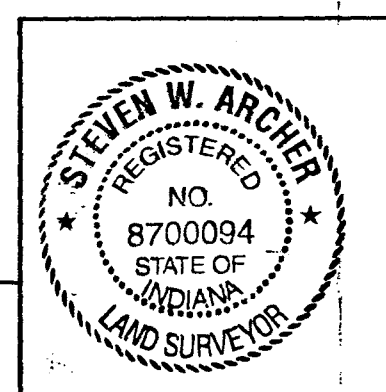


Steve Archer
P.O. Box 1296
Bloomington, IN 47402
(812) 334-8941
Fax (812) 323-7699

JANETT LOWES BOUNDARY SURVEY
A PART OF THE NORTH HALF OF SECTION 32, T-10-N, R-1-E
MONROE COUNTY, INDIANA

PROJECT LOCATION

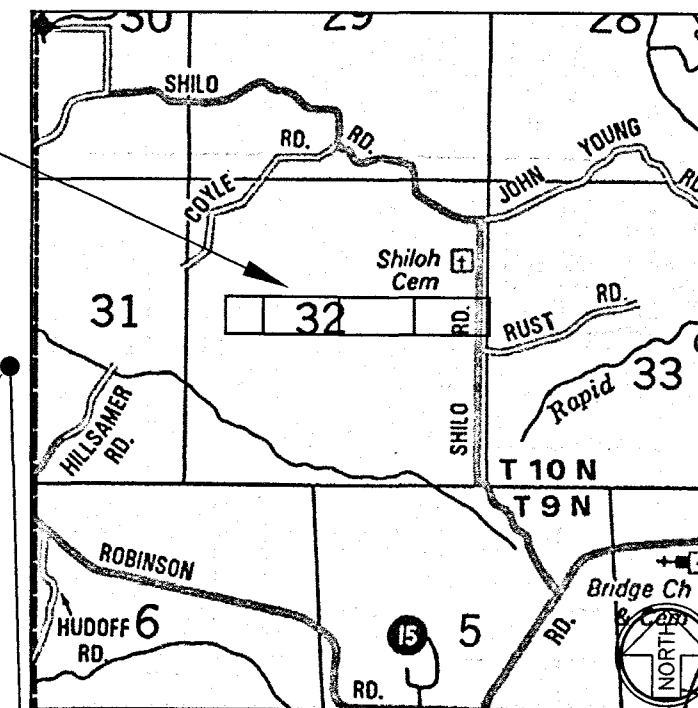

DECKARD
LAND SURVEYING
604 S. HENDERSON STREET
BLOOMINGTON IN. 47401
TELEPHONE (812)961-0235
FAX (812)323-7536
ERIC@DECKARD1@MSN.COM

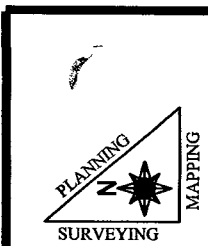

JANETT LOWES
BOUNDARY SURVEY
A PART OF SECTION 32 T10N, R1E

[illegible]

SURVEYED	AW & ED
DRAFTED	ELD
CHECKED	ELD
DATE	12/27/10

JOB NUMBER
10-134

1
OF
2

DATE 12/27/10

BNDY.SHT

- 1) ⁵/₈" Rebar will be set at all property corners.
- 2) Fieldwork completed December 2010.
- 3) Basis of bearing (State Plane).
- 4) Source of title Now or Formerly owned by Burns, Roubidoux, Lowes, Douglass as found in Deed Record 272, Page 81 in the office of the Monroe County Recorder.
- 5) Reference is made to a survey performed by Douglas R. Curry for William C. Link dated February 11th, 1999 (Survey Book 5, Page 244).
- 6) Reference is made to a survey performed by Bledsoe Riggett Guernettez for Richard Palmer (Project No. 7040) dated November 2010(A).
- 7) Reference is made to Survey Book 2, Pages 2 and 139 and found in the office of the Monroe County Surveyor.
- 8) I affirm, under penalty for perjury, that I have taken responsible care to redact each Social Security number in this document, unless required by law.

■ STONE FOUND
 ∅ UTILITY POLE
 ⊗ REBAR FOUND
 ● REBAR SET
 • PK NAIL SET
 ✕ RR SPIKE FOUND
 □ PIPE FOUND
 ○ CALCULATED
 △ MAG SPIKE SET
 FENCE
 TREE LINE
 N/F NOW OR FORMERLY



The within survey was performed without the benefit of source of title and is subject to any statement of facts revealed by the same.

Easements have been located in the field and prepared with this survey drawing. This qualification will be removed upon receipt and inspection of current title work.

Subject to the above reservation, the survey work shown hereon was performed either by me or under my direct supervision and control and to the best of my knowledge and belief was performed according to the survey requirements in 865 IAC 1-12-1 through 19.

Certified this 27 day of January, 2010.

Eric L. Deckard
Registered Surveyor L# 29900012
State of Indiana

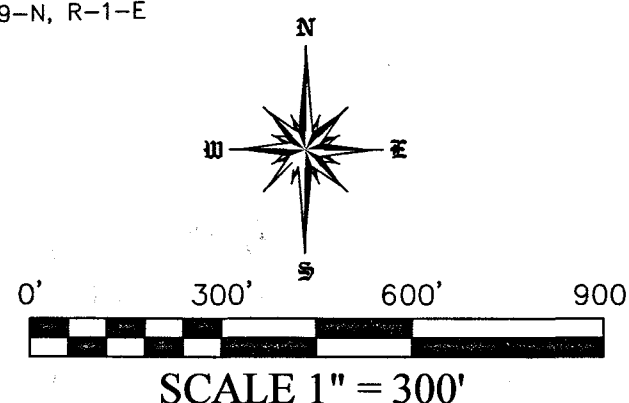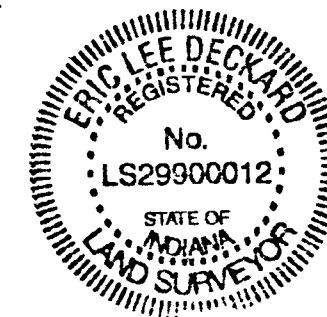

AREA FOR COUNTY
RECORDER

BENTON NORTH TWP.
TOWNSHIP 10 N
RANGE 1 E
SECTION 32

SURVEYOR'S REPORT

In accordance with Title 865, IAC, 1-12 sections 1-30 of the Indiana Administrative Code, the following observations and opinions are submitted regarding the various uncertainties in the location of lines and corners established on this survey as a result of:

- A). (Variances) in the reference monuments
- B). (Discrepancies) in the record description and plats
- C). (Inconsistencies) in lines of occupation and;
- D). (Relative Positional Accuracy) "RPA"

The relative positional accuracy (due to random errors in measurement) of this survey is within that allowable for a Rural survey (0.26' plus 200 PPM) as defined I.A.C. Title 865 ("relative positional accuracy" means the value expressed in feet or meters that represents the uncertainty due to random errors in measurements in the location of any point on a survey relative to any other point on the same survey at the 95 percent confidence level.)

SUBJECT PROPERTY:

A boundary survey was performed on the property now or formerly owned by Judith Ann Burns an undivided 1/6th interest; Joanne Burns Roubush an undivided 1/6th interest; Jannett Burns Lowes an undivided 1/6th interest; Jill Burns Douglas an undivided 1/6th interest John Jay Burns an undivided 1/6th interest; and Jane Ellen Burns an undivided 1/6th interest (Deed Record 272, Pg. 181). The purpose of this survey is to retrace the boundary lines of subject property located in the North half of Section 32, Township 10 North, Range 1 East, Monroe County, Indiana.

REFERENCE MONUMENTS:

A. A Brass Rod with 1-1/2 inch brass cap was found 2 inches above grade marking the Northeast corner of the Northeast quarter of Section 32, Township 10 North, Range 1 East. This monument was found to be of record as Corner I.D. "Benton No G-21" in the office of the Monroe County Surveyor. This rod was found to be the best evidence available and was accepted and held as said corner.

Ex. No. G-23
B). A 4" x 6" sandstone with "+" was found 2 inches above grade marking the Southeast corner of the Northeast quarter of Section 32, Township 10 North, Range 1 East. This monument was found to be referenced as Corner 1.D.
"BenNo G-23" in the office of the Monroe County Surveyor. This corner was also found to be referenced in Survey Book 2, page 139 in a survey performed by John M. McCoy dated December 31st 1867, and January 1st, 1868.

C). A 1/2 inch iron pipe was found 1.0 foot above grade in an east and west running fence marking the Southwest corner of the Southeast quarter of the Northeast quarter of Section 32, Township 10 North, Range 1 East. This pipe was found to be referenced two (2) surveys: 1). A retracement survey performed by Bledsoe Riggert Guerretz for Richard Palmer (Project No. 7040) dated November 2010; 2). Robert C. Sipes dated July 26th, 1980. This monument was found to be the best evidence available and was accepted and held.

D). A Stone was found marking the Northwest corner of the Southeast quarter of the Northeast quarter of Section 32, Township 10 North, Range 1 East. This stone was calculated per a survey performed by Douglas R. Curry for William C. Link dated February 11th, 1999 (Survey Book 5, Page 244). The monument was found to be referenced in a survey performed by James W. Spencer (Monroe County Surveyor) dated March 3rd, 1859 found in Survey Book 2, Page 2 and was accepted and held as said corner.

E). A 6" x 6" sandstone with "+" was found 6 inches above grade marking the Southwest corner of the Southeast quarter of the Northwest quarter of Section 32, Township 10 North, Range 1 East. This stone was found to be set in a survey performed by James W. Spencer (Monroe County Surveyor) dated March 3rd, 1859 found in Survey Book 2, Page 2 and was accepted and held as said corner.

F). A stone was found marking the Northwest corner of the Southeast quarter of the Northwest quarter of Section 32, Township 10 North, Range 1 East. This stoned was calculated per a survey performed by Douglas R. Curry for William C. Link dated February 11th, 1999 (Survey Book 5, Page 244). The monument was found to be referenced in a survey performed by James W. Spencer (Monroe County Surveyor) dated March 3rd, 1859 found in Survey Book 2, Page 2 and was accepted and held as said corner.

AREA FOR COUNTY RECORDER

JANETT LOWES BOUNDARY SURVEY
A PART OF THE NORTH HALF OF SECTION 32, T-10-N, R-1-E
MONROE COUNTY, INDIANA

SURVEY DESCRIPTION

TRACT I

A part of the South half of the Southeast quarter of the Northeast quarter of Section 32, Township 10 North, Range 1 East, Monroe County, Indiana, being more particularly described as follows:

Beginning at a pipe found marking the Southwest corner of the Southeast quarter of the Northeast quarter of said Section 32; thence North 01 degree 16 minutes 43 seconds West along the west line of said quarter quarter for a distance of 658.33 feet to a rebar found stamped "Bynum Fanyo" marking the Northwest corner of the South half of the Southeast quarter of the Northeast quarter of said Section 32; thence North 88 degrees 21 minutes 32 seconds East along the north line of said South half for a distance of 1173.10 feet to the centerline of Shiloh Road, passing through a rebar set stamped "Deckard" at N 1150.30 feet; thence South 00 degrees 21 minutes 53 Seconds West along said centerline for a distance of 660.97 feet to the south line of the Southeast quarter of the Northeast quarter of said Section 32; thence along said south line South 88 degrees 28 minutes 13 seconds West for a distance of 1154.13 feet to the Point of Beginning, passing through a rebar set stamped "Deckard" at 26.64 feet, containing 17.62 acres more or less.

Subject to the right-of-way of Shiloh Road and all easements of record.

TRACT II

The South half of the Southwest quarter of the Northeast quarter of Section 32, Township 10 North, Range 1 East, Monroe County, Indiana, being more particularly described as follows:

Beginning at a pipe found marking the Southeast corner of the Southwest quarter of the Northeast quarter of said Section 32; thence South 88 degrees 41 minutes 22 seconds West along the south line of said quarter quarter for a distance of 1332.45 feet to a rebar set stamped "Deckard" marking the Southwest corner of the Southwest quarter of the Northeast quarter of said Section 32; thence North 01 degree 06 minutes 22 seconds West along the west line of said quarter quarter for a distance of 659.80 feet to a rebar set stamped "Deckard" marking the Northwest corner of the South half of the Southwest quarter of the Northeast quarter of said Section 32; thence North 88 degrees 45 minutes 08 seconds East along the north line of said South half for a distance of 1330.46 feet to a rebar found stamped "Bynum Fanyo" marking the Northeast corner of the South half of the Southwest quarter of the Northeast quarter of said Section 32; thence South 01 degree 16 minutes 43 seconds East along the east line of said South half for a distance of 658.33 feet to the Point of Beginning, containing 20.14 acres more or less.

Subject to all easements of record.

CERTIFICATION

The within survey was performed without the benefit of source of title and is subject to any statement of facts revealed by the same.

Easements have been located in the field and prepared with this survey drawing. This qualification will be removed upon receipt and inspection of current title work.

Subject to the above reservation, the survey work shown hereon was performed either by me or under my direct supervision and control and to the best of my knowledge and belief was performed according to the survey requirements in 865 IAC 1-12-1 through 19

Certified this 27 day of December, 2010.

Eric L. Deckard
Registered Surveyor LS 29900012
State of Indiana

TRACT IV

The Southeast quarter of the South, west quarter of the Northwest quarter of Section 32, Township 10 North, Range 1 East, Monroe County, Indiana, being more particularly described as follows:

Beginning at a stone found marking the Southeast corner of the Southwest quarter of the Northwest quarter of said Section 32; thence South 87 degrees 15 minutes 43 seconds West along the south line of said quarter quarter for a distance of 657.07 feet to a rebar set stamped "Deckard" marking the Southwest corner of the Southeast quarter of the Southwest quarter of the Northwest quarter of said Section 32; thence North 00 degrees 54 minutes 21 seconds West along the west line of said quarter quarter for a distance of 659.63 feet to a rebar set stamped "Deckard" marking the Northwest corner of the Southeast quarter of the Southwest quarter of the Northwest quarter of said Section 32; thence North 87 degrees 45 minutes 44 seconds East along the north line of said quarter quarter for a distance of 659.42 feet to rebar found stamped "Bynum Fano" marking the Northeast corner of the Southeast quarter of the Southwest quarter of the Northwest quarter of said Section 32; thence South 00 degrees 41 minutes 09 seconds East along the east line of said quarter quarter for a distance of 653.95 feet to the Point of Beginning, containing 9.92 acres more or less.

Subject to all easements of record.

TRACT III

The South half of the Southeast quarter of the Northwest quarter of Section 32, Township 10 North, Range 1 East, Monroe County, Indiana, being more particularly described as follows:

Beginning at a stone found marking the Southwest corner of the Southeast quarter of the Northwest quarter of said Section 32; thence North 00 degrees 41 minutes 09 seconds West along the west line of said quarter quarter for a distance of 653.95 feet to a rebar found stamped "Bynum Fanyo" marking the Northwest corner of the South half of the Southeast quarter of the Northwest quarter of said Section 32; thence North 88 degrees 26 minutes 10 seconds East along the north line of said South half for a distance of 1330.48 feet to a rebar set stamped "Deckard" marking the Northeast corner of the South half of the Southeast quarter of the Northwest quarter of said Section 32; thence South 01 degree 06 minutes 22 seconds East along the east line of said quarter quarter for a distance of 659.80 feet to rebar set stamped "Deckard" marking the Southeast corner of the Southeast quarter of the Northwest quarter of said Section 32; thence South 88 degrees 41 minutes 22 seconds West along the south line of said quarter quarter for a distance of 1335.24 feet to the Point of Beginning, containing 20.10 acres more or less.

Subject to all easements of record.

DECKARD
LAND SURVEYING
1604 S. HENDERSON STREET
BLOOMINGTON IN. 47401
TELEPHONE (812)961-4023
FAX (812)32-7536
ERICDECKARDI@MSN.COM




JANETT LOWES
BOUNDARY SURVEY
A PART OF SECTION 32 T10N, R1E

[illegible]

SURVEYED	DRAFTED	CHECKED	DATE
AW & ED	ELD	ELD	12/27/10

JOB NUMBER
10-134
SHEET
2
OF
2
DATE
12/27/10
BNDY.SHT

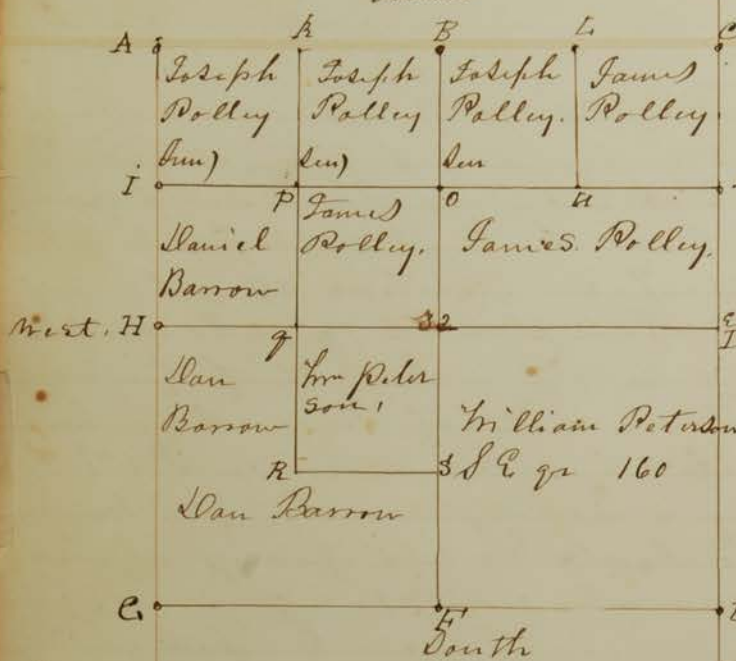

ran the following lines and
made the following corners in
Section No 32, T. 10. R. 1. East
for Joseph Polley, (Sen) Joseph
East Polley, Jun John A. Polley
James Polley, Daniel Barrow
and William Peter Son,

length of the line from the North
1/2 mile post to the South 1/2 mile
321. poles 12. in. h. Sep. 60. in h.

length of the line North of
the center of said section
No 32, 138.22

Length South Sea 16 6. 10.

length East Lo " 161. 08-

length West 200'

Stone planted at (g) and. Mitered. Trees made 80. poles 15 links
west of the eastern white oak 6 inches diameter S 87° E 5 1/2
links. distant red oak 15 inches diameter N 17° W. 11. links
distant length of the line from the north west corner to
the nestons 1/2 mile post 160 poles 18 1/2 links stone planted
at (i) 80. poles 9 1/4 links. north of the nestons 1/2 mile post
B oak 15 inches diameter N 19° W 13 1/2 links. Hickory 4 inches
diameter N 35° E 21 1/2 links. distant

nitrop. Lices, made and stone planted at the center of the section
no 32, Black Oak 10 inches diameter A $27\frac{1}{2}^{\circ}$ E 21 links distant
Black Oak, 12 inches diameter A 44° N 18 links distant.

Length of the line from the A & C corner of Section 32 to the
Northern 1/2 mile Post 162 poles $7\frac{1}{3}$ links. S. p. 169. Link
corner made at (K) equidistant from the North West corner
of Sec No 32, ~~intersects~~ leads to the Northern 1/2 mile Bench 15 in
ches diameter at $89\frac{1}{2}$ ft. 41 links distant.

Length of the line from the North west corner to the Northern
1/2 mile post 162 poles $7\frac{1}{3}$ links

Corner made at (11) the South East West Corner of North East
1/4 of North East quarter Birch 12 inches diameter $A 83^{\circ} E 33.60$
distant 100

distant maple 10 inches diameter N 15° W. 30 links distant
corner made at (P) the South East corner of the North West

44. of North west quarter of Section No 32 Black oak 6
inches diameter N 13° E 16 links dist white oak 30 inches

diagonal A 88 $\frac{1}{2}$ to 28 links distant corner made 81 poles 12
links south of the center Hickory 5 inches diameter A 32 $\frac{1}{2}$ E
7 links distant White oak 5 inches diameter A 72 $\frac{1}{2}$ to 9
links distant corner made at (B) the center of south
west quarter of Section No 32, white walnut 18 inches diam
S 77 $\frac{1}{2}$ E 41 links distant white oak 15 inches diameter A 24 $\frac{1}{2}$ E
44 $\frac{1}{2}$ links distant length of the line from A to A 80 poles
length from A to B 80 poles length of the line west of the
center 159 poles 17 links. length of the line from from
the corner standing $\frac{1}{4}$ mile west of the Eastern $\frac{1}{2}$ mile
part of Section No 32) 241 poles 20 links to (C)

Chain Bearers in Section 32. Thomas Peter son John
A Polley James Polley & Joseph Polley (Jr) sworn
this March 3^d A.D. 1859.

James W. Spencer
Monroe County Surveyor

April 25th A.D. 1859.

ran the following lines and made the following corners
in Section No 18 Township No 8 North of Range No 1 East
for Henderson Ellis John C Johnston John Garrison & Joseph
Shields beginning at a stone standing at the S E corner of
the A to $\frac{1}{4}$ of A E quarter of Section No 18 witness Live Birch
30 inches diameter S 57 $\frac{1}{2}$ E 15 $\frac{1}{2}$ links dist Dogwood 5 in diam
A 67 $\frac{1}{2}$ E 32 $\frac{1}{2}$ links dist then S 6 $\frac{1}{2}$ E 154 poles 15 links to a stone
at the A E cor of S to $\frac{1}{4}$ of S E quarter of said Section (18
witness Birch 18 in diameter S 1 $\frac{1}{2}$ E 6 links dist Maple 12
inches diam A 20 $\frac{1}{2}$ to 13 links distant

James Ellis and John Armstrong chain bearers by
consent of Parties

James W. Spencer
Monroe County Surveyor.

November 19th A.D. 1863.

ran the following lot of land for the benefit of
 Sarilda Polley widow of James C. Polley late of
 Monroe County Indiana Decd^d situate in the North
 East quarter of the North east quarter of Section No 32.
 Township No 10 north of Range No one east Beginning
 29 poles & 8 links west of the North east corner of said
 Section No 32. at a stone witness tree Black Ash 18 inches
 diameter S 35° E 73 1/2 links distant then S 1° E 80 poles
 to a stone witness tree red oak 16 inches diameter
 N 76 1/2° W 56 links distant then west 30 poles & 13 links
 to a stone then north 80 poles to a stone then east
 51 poles & 17 1/2 links to the beginning containing 25 acres
 and one half

Chain bears. Joseph Polley (Sen) & Joseph C.
 Bates by consent of parties. Sarilda Polley & William
 C. Brown.

James H. Spencer
 Monroe County Surveyor.

November 24th A.D. 1863.

Surveyed for Reuben Clark (Sen) Adam Sheekard William
 Shields. Michael Trampers. Hiram Hayless Miz. & Polley
 Section No 31 Township No 8 north of Range No one
 East of the 2nd principal Meridian.

length of the line East & west through the center 316 poles & 4 links.
 length of the line North & South through the center 320 poles 17 links
 corner made 160 poles ^{10 1/2 links} East of the Sth corner of said Section
 or at the Southern 1/2 mile post witness tree none made but
 planted a stone

length of the line from the Sth corner to the South East
 corner 321 poles & 4 links.

length of the line from the North west corner to the South
 west corner 324 poles & 24 links.

corner made at the western 1/2 mile post ~~on half~~ by
 planting a stone witness tree Beech ¹⁵/₄ inches diameter
 S 90° E ³¹/₄ links distant Beech 30 inches diam N 63° W 43 links dist
 corner made 80 poles & 6 links north of the South west
 corner of said Section No 31.

September the 13th 1861

Ran the following lines and made the following corners
in Section 3, T. 8, R. 1, E for Samuel H. Stephens
commenced at center of the N. E. $\frac{1}{4}$ of $\frac{1}{36}$ T. 8, R. 1, E at rock
ran S 86° W 158 poles + 20 links corner made witness trees
Buck 5 inches in diameter N 55° E 2.3 lbs dist

Sugar 10 " " " " " " " " " "

thens N 51° W 17 poles + 5 links corner made witness trees

Buck 18 inches in diameter S 76½° E 16 lbs dist

To 20 " " " " " " " " " "

thens N 81° E 158 poles + 20 links corner made witness trees

Buck 20 inches in diameter N 71° E 2.1 lbs dist

To 8 " " " " " " " " " "

thens S 1° E 17 poles + 5 links to the place of beginning

Chas Barer } Samuel H. Stephens } sworn
Henderson A Myers }

for \$3-00 paid \$2-00

J. S. Buskirk M. C. S.

November the 23rd 1861

by an Order of the Circuit Court of Monroe County
Indiana made in cause where in James C. Polley is plaintiff
& John A. Polley Defendant Made the following Survey
on the line dividing Sections twenty nine and thirty
two Township No ten North of Range No one East
commencing S E corner of 29 & N E corner of 32
ran S 81° W 81 poles + 5 links corner made & rock planted
witness trees R Oak 3 inches in diameter N 60° W 26½ links
distant Buck 18 inches in diameter S 1½° W 9.1 links dist
thens S 81° W 81 poles + 5 links to the ½ mile post on said
line the above Survey & corner is to supersede a Survey
made by James W. Spencer in March 1859 and corner
E made by him at that time

Chas Barer Joseph C. Polley & James Turner Flag Barer
Joseph Polley sen Marker John A. Polley all sworn by
me this 23rd day of November 1861 J. S. Buskirk M. C. S.
for \$2-00 charged with other costs paid